

Customer Information Sheet

DRAWING No.: D3083-XX

SHEET 2 OF 2


IF IN DOUBT - ASK

©

NOT TO SCALE

THIRD ANGLE PROJECTION

ALL DIMENSIONS IN mm

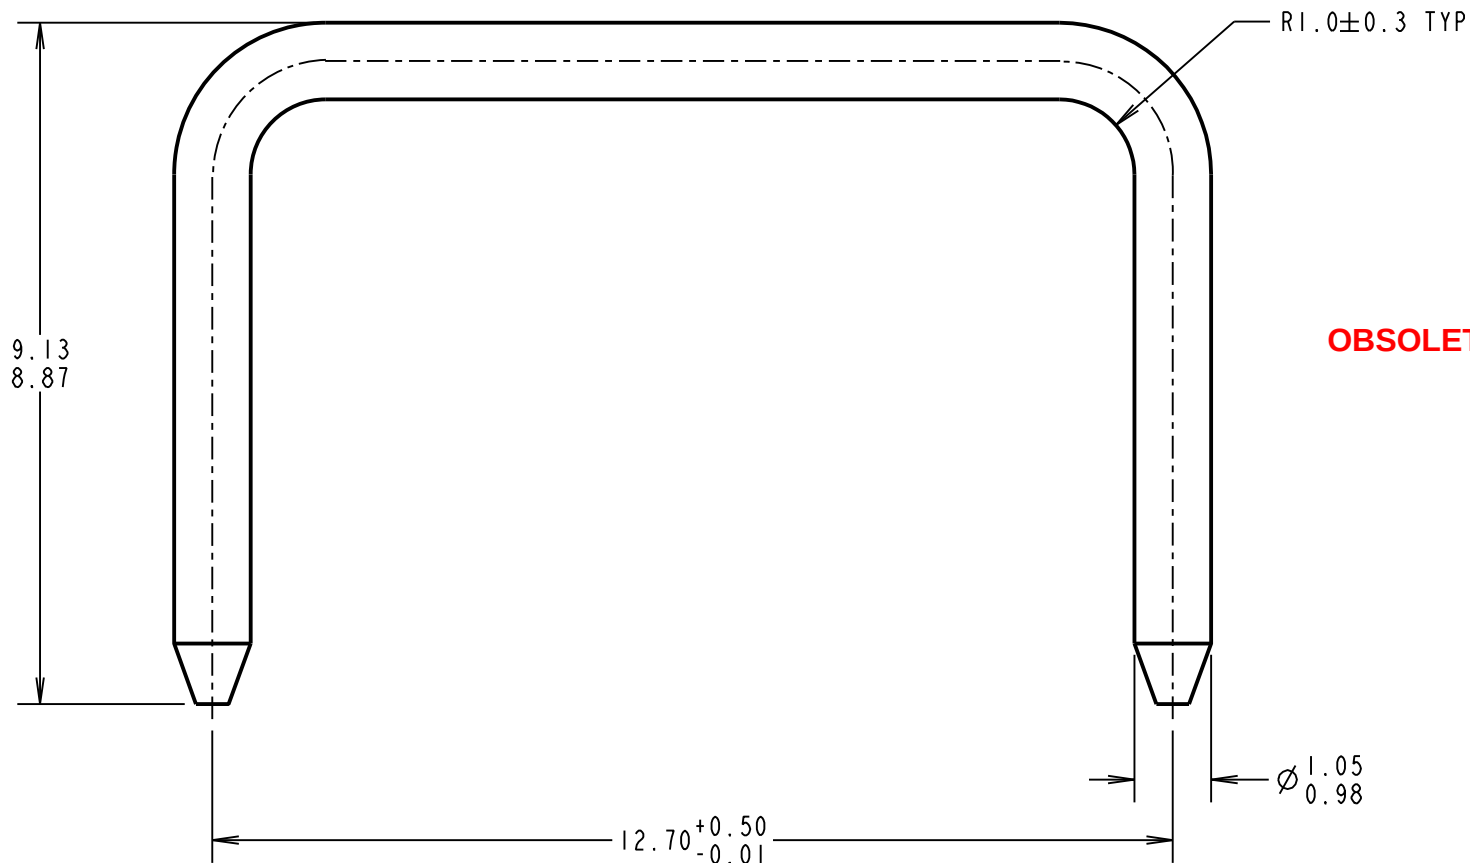

ORDER CODE:

D3083-XX

FINISH:

~~01 = 100% MATTE TIN~~
~~05 = GOLD FLASH~~
46 = 100% BRIGHT TIN

OBSOLETE

SB	10	18.12.12	11891
NAME	ISS.	DATE	C/NOTE
APPROVED:		S.BENNETT	
CHECKED:		S.FLOWER	
DRAWN:		C. HANSEN	
CUSTOMER REF.:			
ASSEMBLY DRG:			
D3089-XX			

PART No.	FINISH
D3083-01	2.54µ 100% MATTE TIN OVER 0.76µ NICKEL UNDERCOAT
D3083-05	GOLD FLASH OVER 0.76µ NICKEL UNDERCOAT
D3083-46	2.54µ 100% BRIGHT TIN OVER 0.76µ NICKEL UNDERCOAT

HARWIN

www.harwin.com
technical@harwin.com

THIS DRAWING AND ANY
INFORMATION OR DESCRIPTIVE
MATTER SET OUT HEREON ARE
CONFIDENTIAL AND COPYRIGHT
PROPERTY OF THE HARWIN
GROUP AND MUST NOT BE
DISCLOSED, LOANED, COPIED
OR USED FOR MANUFACTURING,
TENDERING OR FOR ANY
OTHER PURPOSE WITHOUT
THEIR WRITTEN PERMISSION.

TOLERANCES
X. = ±1mm
X.X = ±0.25mm
X.XX = ±0.10mm
X.XXX = ±0.01mm
ANGLES = ±5°
UNLESS STATED

MATERIAL:

BRASS C2600

FINISH: SEE ABOVE

S/AREA:

mm²

TITLE:

1mm SHORTING LINK

DRAWING NUMBER:

D3083-XX

SHT
2
OF
2