

© COPYRIGHT 1977 BY AMP INCORPORATED, HARRISBURG, PA.
ALL INTERNATIONAL RIGHTS RESERVED. AMP INCORPORATED PRODUCTS
COVERED BY U. S. AND FOREIGN PATENTS AND/OR PATENTS PENDING.

3 207438-2 1. AS SHOWN.

207438-3

1. SAME AS -2 EXCEPT:
2. LOOSE PIECE

207438-5

1. SAME AS -2 EXCEPT:
2. LOOSE PIECE

REVISIONS				
P. F.	ZONE	LTR	DESCRIPTION	DATE
✓		G	OBSOLETE - 57 ECU-R-2613	12-87
✓		H	REV PER EC 0020 - 289-93	5-3-93

1 Loc BD DIST 39


~~OBSOLETE EXCEPT:~~
1. SELECT GOLD/NI PLATED.

~~OBSOLETE EXCEPT:~~
2. LOOSE PIECE.

3 -8 1. SAME AS -6 EXCEPT:
2. GOLD FLASH / NI PLATED.

DID MAX CUTOFF -9 1. SAME AS -8 EXCEPT:
(-3, -5, -7 & -9 ONLY) 2. LOOSE PIECE.

POINT OF PLATING
THICKNESS MEASURE-
MENT (SIDE OPPOSITE
SEAM)

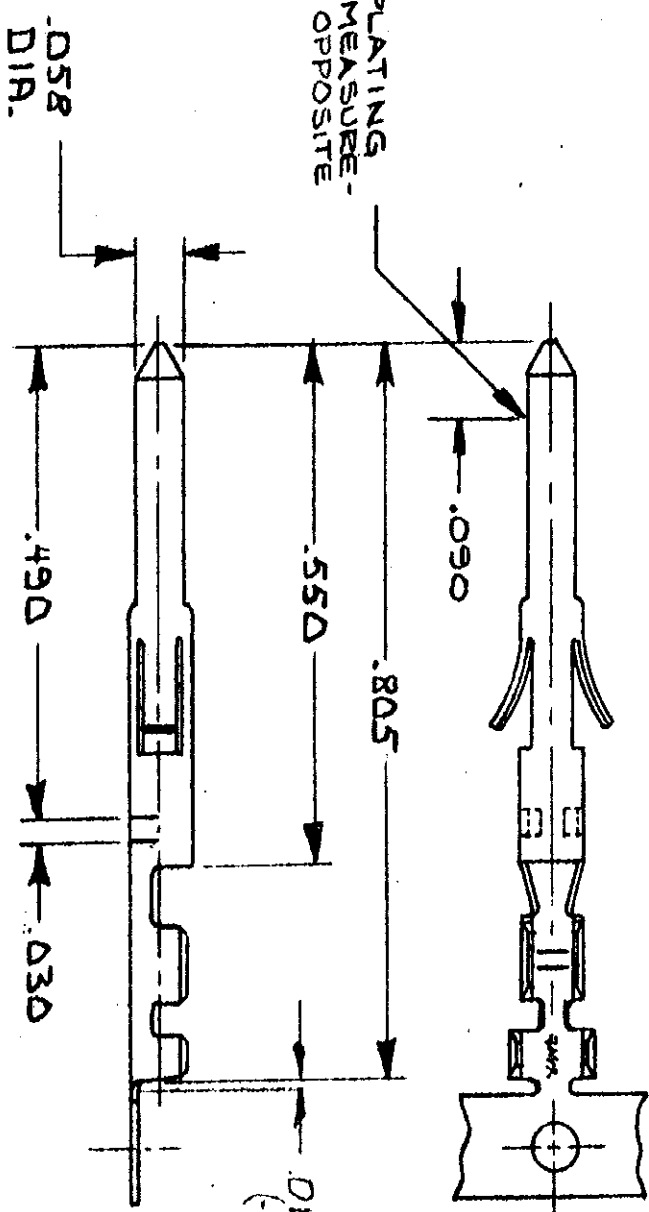

1. WIRE RANGE = 22-28.
2. INSULATION RANGE = .036-.054 DIA.
3. REVERSE REELED FOR MINI-APPLICATOR.

UNLESS OTHERWISE
SPECIFIED DIMENSIONS
ARE IN INCHES.
TOLERANCES ON:
DECIMALS ± .005
ANGLES ± .1°

MATERIAL

BRASS

FINISH

FIN WHITE

CONTRACT NO

DR 3-2-77

CHK Q. Wick

APPROV WICK 3/2/77

APPROV Wick 3/2/77

DESIGN APPRO

OTHER APPRO

NAME

CONTACT, PIN

SIZE CODE IDENT NO DRAWING NO

B 00779 207438

SCALE 1:1 SHEET 1 OF 1

PART NO

AMP INCORPORATED
Harrisburg, Pa.