THIS DRAWING IS UNPUBLISHED. RELEASED FOR PUBLICATION - ,- .
© COPYRIGHT - By - ALL RIGHTS RESERVED.

LOC	DIST
AD	00

REVISIONS

P	LTR	DESCRIPTION	DATE	DWN	APVD
	S2	REVISED PER ECO-11-004820	11MAR11	RK	HMR

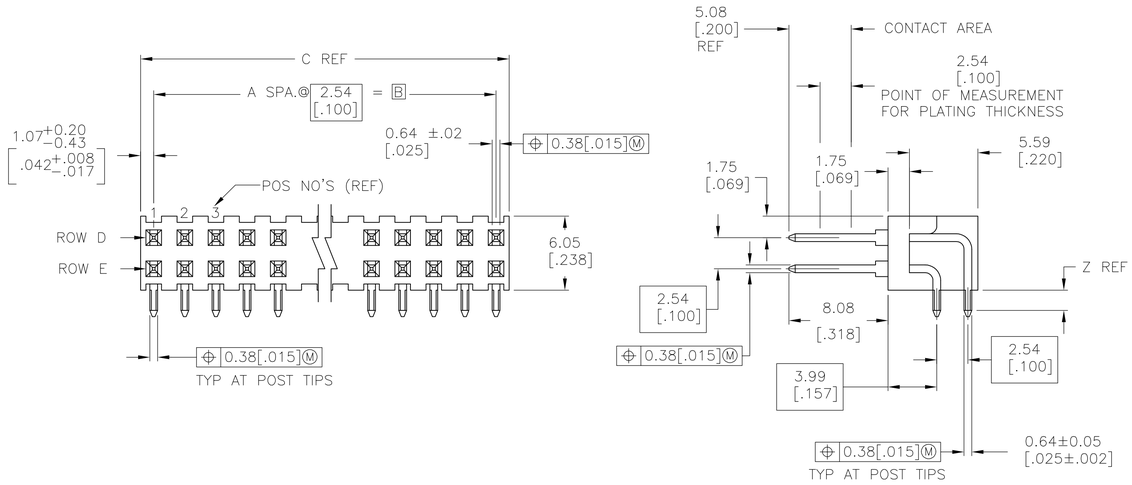

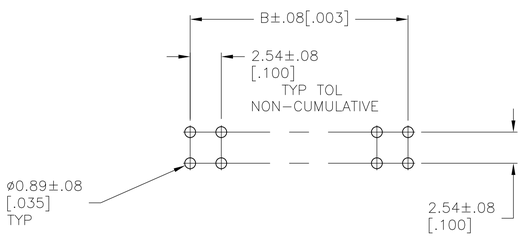

RECOMMENDED BOARD LAYOUT

△1 .000030 GOLD ON CONTACT AREA, GOLD FLASH ON SOLDER AREA, ALL OVER .000050 NICKEL

△2 OBSOLETE PARTS: OBSOLETE CIS STREAMLINING PER D.RENAUD/D.SINISI

△2 OBSOLETE	1,3,6,8,9 1,3,6,8,9	1,3,6,7,14 15,18,20,21	2.79 [.110]	55.47 [2.184]	53.34 [2.100]	21	44	~~4-86479-9~~
△2 OBSOLETE	1,9,15 22,24,29,35	3,11,17	2.79 [.110]	93.57 [3.684]	91.44 [3.600]	36	74	~~4-86479-6~~
OBSOLETE	3	4	2.79 [.110]	24.99 [.984]	22.86 [.900]	9	20	4-86479-5
	NONE	NONE	2.79 [.110]	101.19 [3.984]	99.06 [3.900]	39	80	4-86479-4
△2 OBSOLETE	NONE	NONE	2.79 [.110]	98.65 [3.884]	96.52 [3.800]	38	78	~~4-86479-3~~
	NONE	NONE	2.79 [.110]	96.11 [3.784]	93.98 [3.700]	37	76	~~4-86479-2~~
	NONE	NONE	2.79 [.110]	93.57 [3.684]	91.44 [3.600]	36	74	~~4-86479-1~~
	NONE	NONE	2.79 [.110]	91.03 [3.584]	88.90 [3.500]	35	72	~~4-86479-0~~
	NONE	NONE	2.79 [.110]	88.49 [3.484]	86.36 [3.400]	34	70	3-86479-9
△2 OBSOLETE	NONE	NONE	2.79 [.110]	85.95 [3.384]	83.82 [3.300]	33	68	~~3-86479-8~~
	NONE	NONE	2.79 [.110]	83.41 [3.284]	81.28 [3.200]	32	66	3-86479-7
	NONE	NONE	2.79 [.110]	80.87 [3.184]	78.74 [3.100]	31	64	3-86479-6
△2 OBSOLETE	NONE	NONE	2.79 [.110]	78.33 [3.084]	76.20 [3.000]	30	62	~~3-86479-5~~
	NONE	NONE	2.79 [.110]	75.79 [2.984]	73.66 [2.900]	29	60	3-86479-4
△2 OBSOLETE	NONE	NONE	2.79 [.110]	73.25 [2.884]	71.12 [2.800]	28	58	~~3-86479-3~~
	NONE	NONE	2.79 [.110]	70.71 [2.784]	68.58 [2.700]	27	56	3-86479-2
△2 OBSOLETE	NONE	NONE	2.79 [.110]	68.17 [2.684]	66.04 [2.600]	26	54	~~3-86479-1~~
	NONE	NONE	2.79 [.110]	65.63 [2.584]	63.50 [2.500]	25	52	~~3-86479-0~~
	NONE	NONE	2.79 [.110]	63.09 [2.484]	60.96 [2.400]	24	50	2-86479-9
△2 OBSOLETE	NONE	NONE	2.79 [.110]	60.55 [2.384]	58.42 [2.300]	23	48	~~2-86479-8~~
	NONE	NONE	2.79 [.110]	58.01 [2.284]	55.88 [2.200]	22	46	~~2-86479-7~~
	NONE	NONE	2.79 [.110]	55.47 [2.184]	53.34 [2.100]	21	44	2-86479-6
△2 OBSOLETE	NONE	NONE	2.79 [.110]	52.93 [2.084]	50.80 [2.000]	20	42	~~2-86479-5~~
	NONE	NONE	2.79 [.110]	50.39 [1.984]	48.26 [1.900]	19	40	2-86479-4
△2 OBSOLETE	NONE	NONE	2.79 [.110]	47.85 [1.884]	45.72 [1.800]	18	38	~~2-86479-3~~
	NONE	NONE	2.79 [.110]	45.31 [1.784]	43.18 [1.700]	17	36	~~2-86479-2~~
	NONE	NONE	2.79 [.110]	42.77 [1.684]	40.64 [1.600]	16	34	~~2-86479-1~~
	NONE	NONE	2.79 [.110]	40.23 [1.584]	38.10 [1.500]	15	32	~~2-86479-0~~
	NONE	NONE	2.79 [.110]	37.69 [1.484]	35.56 [1.400]	14	30	1-86479-9
	NONE	NONE	2.79 [.110]	35.15 [1.384]	33.02 [1.300]	13	28	1-86479-8
	NONE	NONE	2.79 [.110]	27.53 [1.084]	25.40 [1.000]	10	22	1-86479-7
	NONE	NONE	2.79 [.110]	9.75 [.384]	7.62 [.300]	3	8	1-86479-6
	NONE	NONE	2.79 [.110]	7.21 [.284]	5.08 [.200]	2	6	1-86479-5
	NONE	NONE	2.79 [.110]	4.67 [.184]	2.54 [.100]	1	4	1-86479-4
	NONE	NONE	2.79 [.110]	2.13 [.084]	-	-	2	1-86479-3
OBSOLETE	NONE	NONE	2.79 [.110]	-	-	-	-	1-86479-2
OBSOLETE	NONE	6	2.79 [.110]	24.99 [.984]	22.86 [.900]	9	19	1-86479-1
	NONE	NONE	2.79 [.110]	32.61 [1.284]	30.48 [1.200]	12	26	1-86479-0
SUPERSEDED BY 4-87230-2	NONE	NONE	2.79 [.110]	-	-	-	-	86479-9
SUPERSEDED BY 4-87230-1	NONE	NONE	2.79 [.110]	-	-	-	-	86479-8
	NONE	NONE	2.79 [.110]	30.07 [1.184]	27.94 [1.100]	11	24	86479-7
	NONE	NONE	2.79 [.110]	22.45 [.884]	20.32 [.800]	8	18	86479-6
	NONE	NONE	2.79 [.110]	17.37 [.684]	15.24 [.600]	6	14	86479-5
	NONE	NONE	2.79 [.110]	14.83 [.584]	12.70 [.500]	5	12	86479-4
	NONE	NONE	2.79 [.110]	12.29 [.484]	10.16 [.400]	4	10	86479-3
	NONE	NONE	2.79 [.110]	19.91 [.784]	17.78 [.700]	7	16	86479-2
	NONE	NONE	2.79 [.110]	24.99 [.984]	22.86 [.900]	9	20	86479-1
	ROW E	ROW D	Z	C	B	A	NO OF POSN	PART NUMBER
	POSTS OMITTED							

THIS DRAWING IS A CONTROLLED DOCUMENT.

DIMENSIONS: mm [INCHES]

TOLERANCES UNLESS OTHERWISE SPECIFIED:
0 PLC ± -
1 PLC ± -
2 PLC ± .13 [.005]
3 PLC ± -
4 PLC ± -
ANGLES ± -

MATERIAL: HIGH-FLAME RETARDANT THERMOPLASTIC COLOR-BLACK POSTS- PHOS. BRONZE

FINISH △1

DWN	J KNAUB	16MAY94
CHK	J KNITTLE	17MAY94
APVD	J KNITTLE	17MAY94

PRODUCT SPEC —

APPLICATION SPEC —

WEIGHT —

TE Connectivity

NAME: ASSEMBLY, MOD II, DOUBLE ROW .100 X .100 CL, RIGHT ANGLE WITH SPANKED TAILS

SIZE	CAGE CODE	DRAWING NO	RESTRICTED TO
A1	-	C-86479	—

CUSTOMER DRAWING | SCALE 4:1 | SHEET 1 OF 1 | REV S2