THIS DRAWING IS UNPUBLISHED. RELEASED FOR PUBLICATION , .
© COPYRIGHT 2009 By – ALL RIGHTS RESERVED.

LOC	DIST
A1	

REVISIONS

P	LTR	DESCRIPTION	DATE	DWN	APVD
	Z	Tolerence Value Change for L	6JAN12	MHM	RP

GEGENSTECKER/KONTAKT: [X] 826 629 [X] 167 301–4
MATED WITH:

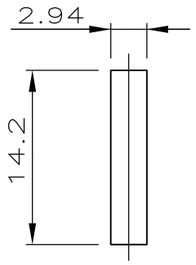

EINREIHIG

POLZ.	L±0.8	BESTELL–NR.	
–	–	–	
2	5.08	925 366 –2	
3	7.62	–3	
4	10.16	–4	
5	12.70	–5	
6	15.24	–6	
7	17.78	–7	
8	20.32	–8	
9	22.86	~~–9~~	OBSOLETE
10	25.40	1– –0	
11	27.94	~~1– –1~~	OBSOLETE
12	30.48	1– –2	
13	33.02	~~1– –3~~	OBSOLETE
14	35.56	1– –4	
15	38.10	1– –5	
16	40.64	1– –6	
17	43.18	1– –7	
18	45.72	1– –8	
19	48.26	1– –9	
20	50.80	~~2– –0~~	OBSOLETE
21	53.34	~~2– –1~~	OBSOLETE △1
22	55.88	~~2– –2~~	OBSOLETE
23	58.42	~~2– –3~~	OBSOLETE △1
24	60.96	~~2– –4~~	
25	63.50	2– –5	
26	66.04	~~2– –6~~	OBSOLETE △1
27	68.58	~~2– –7~~	
28	71.12	~~2– –8~~	
29	73.66	~~2– –9~~	
30	76.20	~~3– –0~~	
31	78.74	~~3– –1~~	
32	81.28	~~3– –2~~	OBSOLETE
33	83.82	~~3– –3~~	OBSOLETE △1
34	86.36	~~3– –4~~	
35	88.90	~~3– –5~~	
36	91.44	~~3– –6~~	OBSOLETE
37	93.98	3– –7	
38	96.52	3– –8	
39	99.06	~~3– –9~~	OBSOLETE △1
40	101.60	~~4– –0~~	
41	104.14	~~4– –1~~	
42	106.68	~~4– –2~~	
43	109.22	~~4– –3~~	
44	111.76	~~4– –4~~	
45	114.30	~~4– –5~~	
46	116.84	~~4– –6~~	
47	119.38	~~4– –7~~	
48	121.92	~~4– –8~~	
49	124.46	~~4– –9~~	
50	127.00	5– 925 366 –0	

△1 OBSOLETE PARTS: OBSOLETE CIS STREAMLINING
PER D.RENAUD/D.SINISI

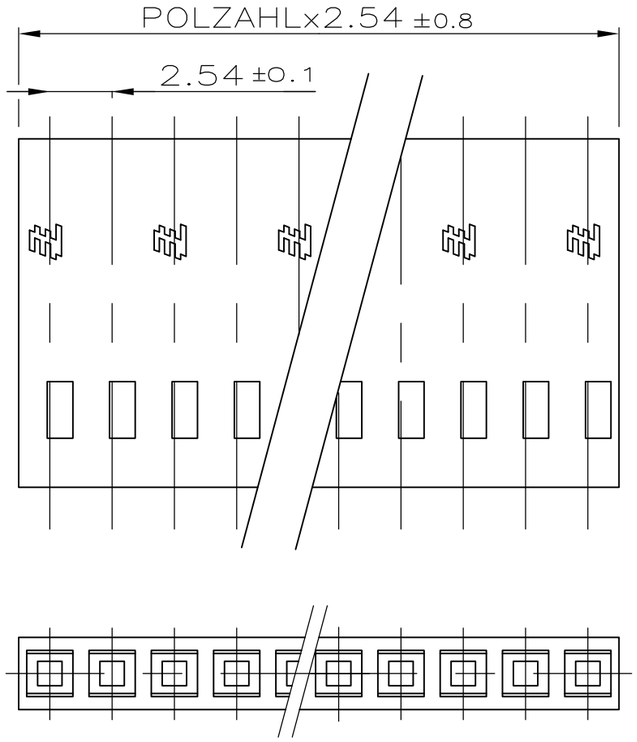

Drawing valid from CW 32/95
ZEICHNUNG GüLTIG AB KW 32/95

THIS DRAWING IS A CONTROLLED DOCUMENT.

DIMENSIONS: mm

TOLERANCES UNLESS OTHERWISE SPECIFIED:
0 PLC ± 0.2
1 PLC ± 0.2
2 PLC ± 0.2
3 PLC ± 0.2
4 PLC ± 0.2
ANGLES ± –

MATERIAL: Polyamid
FINISH: Green RAL 6011

DWN DAHLHEIMER 05.12.75
CHK KREPP
APVD
PRODUCT SPEC —
APPLICATION SPEC —
WEIGHT —

TE Connectivity

NAME: AMPMODU IV GEHAUESE, EINREIHIG
Housing, single row

SIZE	CAGE CODE	DRAWING NO	RESTRICTED TO
A3	00779	C–925366	—

CUSTOMER DRAWING | SCALE 4:1 | SHEET 1 OF 1 | REV Z